



DETAIL A  
SCALE 1:1000

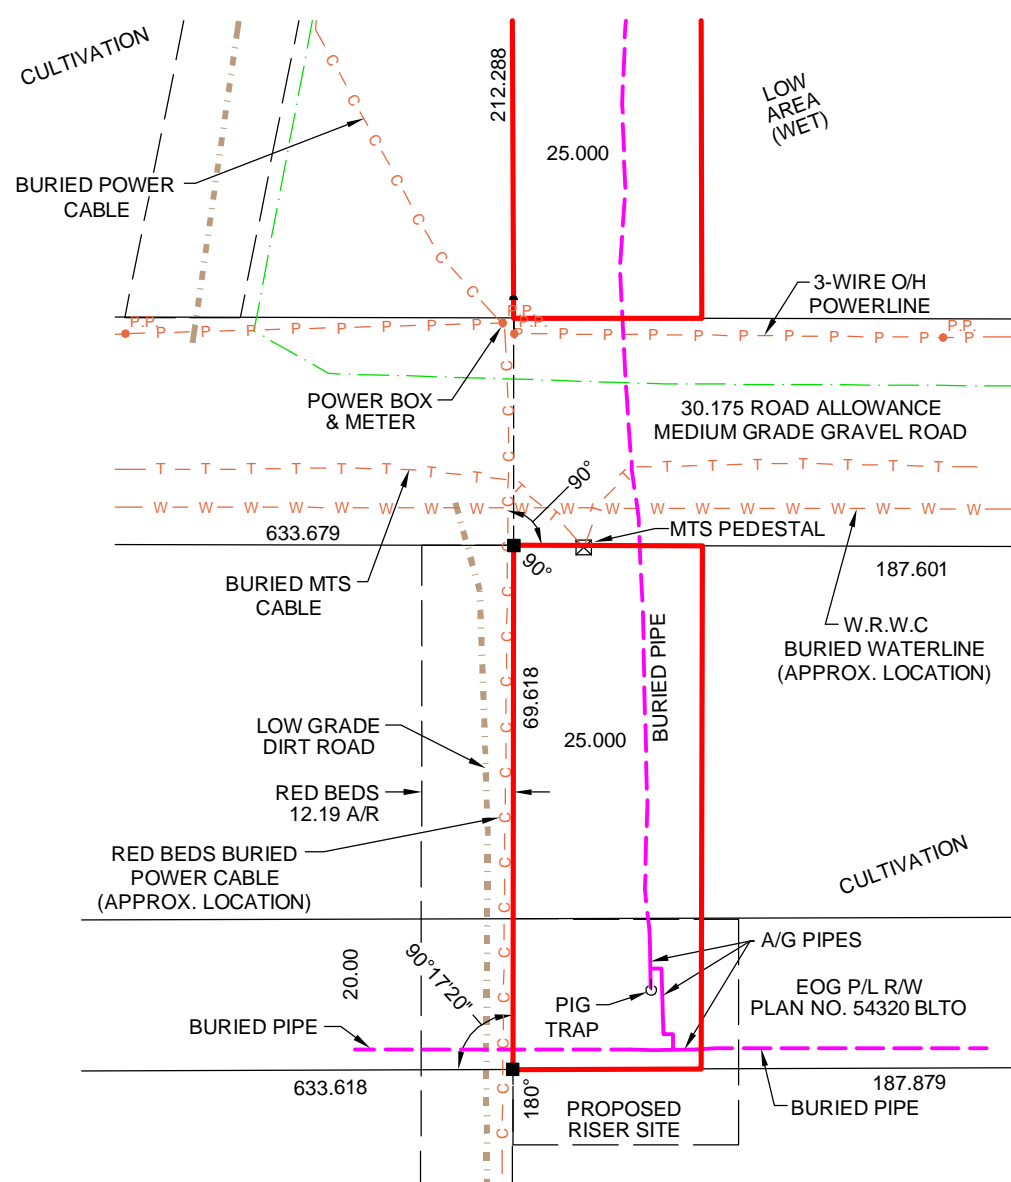

DETAIL B  
SCALE 1:1000

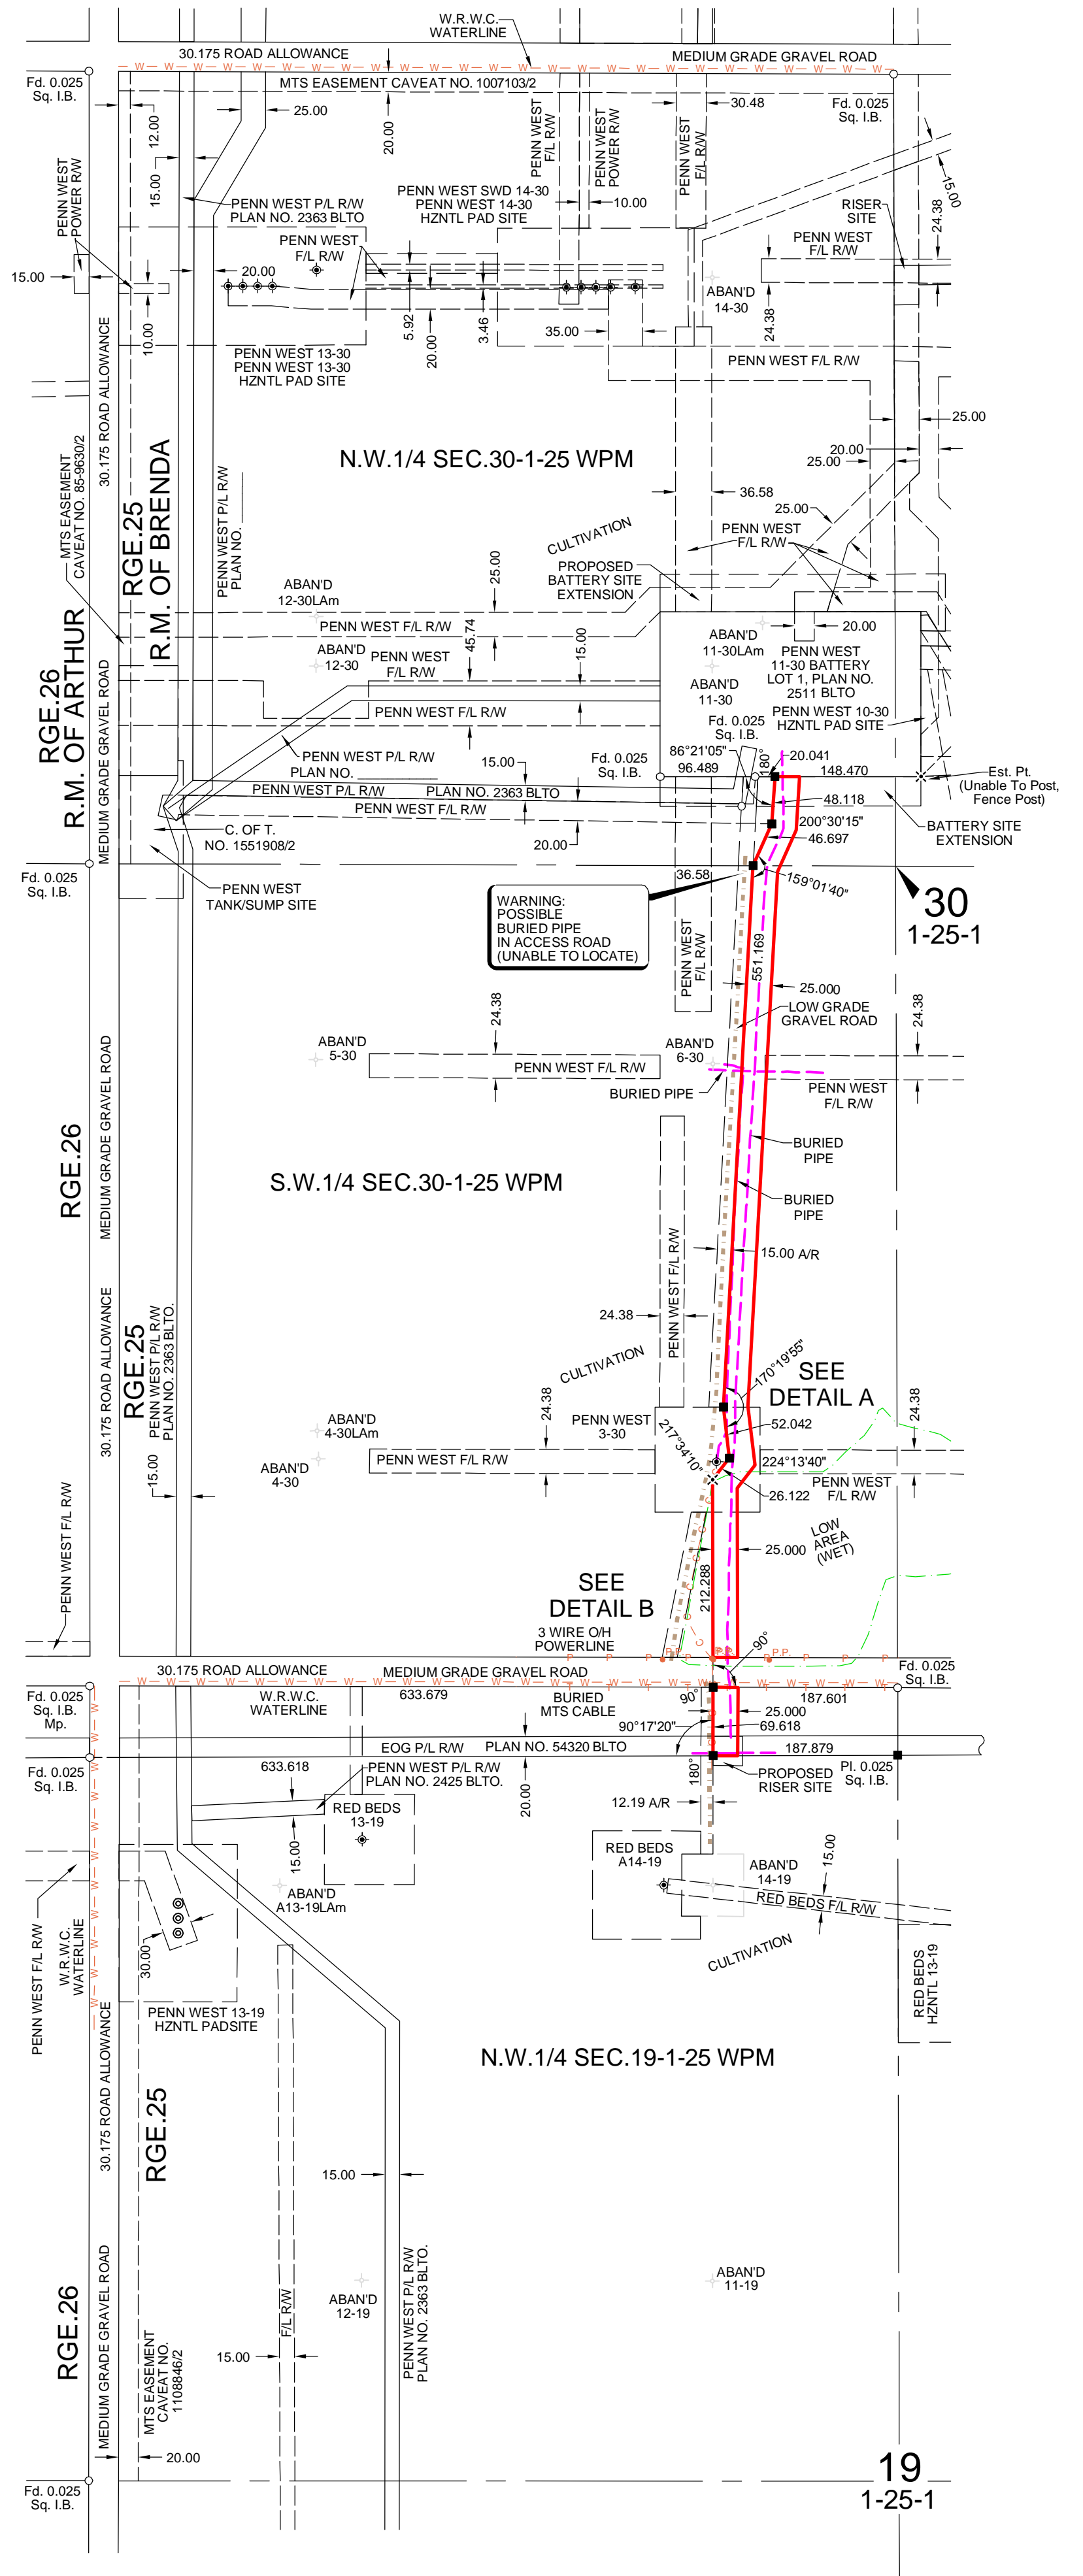

**LEGEND**

- - - - - Buried SaskTel Cable
- - - - - Buried Power Cable
- - - - - Overhead Power Line
- Power Pole
- Buried Pipe
- ⊕ Riser
- - - - - Road Centre Line
- x - x - x - Fence
- ~ ~ ~ ~ ~ Bush
- Building
- /// Berm

**PENN WEST  
PETROLEUM LTD.**

**AS-BUILT SURVEY  
OF  
PIPELINE WITHIN RIGHT OF WAY  
IN  
SECTIONS 19 & 30  
TWP. 1 RGE. 25 WPM  
R.M. OF BRENDA  
SCALE 1:5000**



5			
4			
3			
2			
1			
0	ORIGINAL ISSUE	DECEMBER 10, 2013	ML
NO.	DESCRIPTION	DATE	BY
	REVISION		

**CALTECH**  
SURVEYS LTD.  
Calgary (403) Ph: 263-8055 Fax: 263-8058  
Regina (306) Ph: 775-1814 Fax: 775-1818  
Unity (306) Ph: 228-4366 Fax: 228-4367

281 Nelson Street W.  
Virden, Manitoba R0M 2C0  
Ph: (204) 748-1053 Fax: (204) 748-1059

DRAWN: ML CHECKED: TC CALTECH JOB No: 413-6623 PW FILE No: 13-0061